



This drawing is not for construction purposes

DRAWING Proposed Plans

DRAWING NO. 61_F_02


SCALE 1:50@A3

REV.


DATE January 2023

JOB TITLE 25 Corner Farm Road, Staplehurst

studio fourteen
studio@fourpointten.co.uk
07523194951

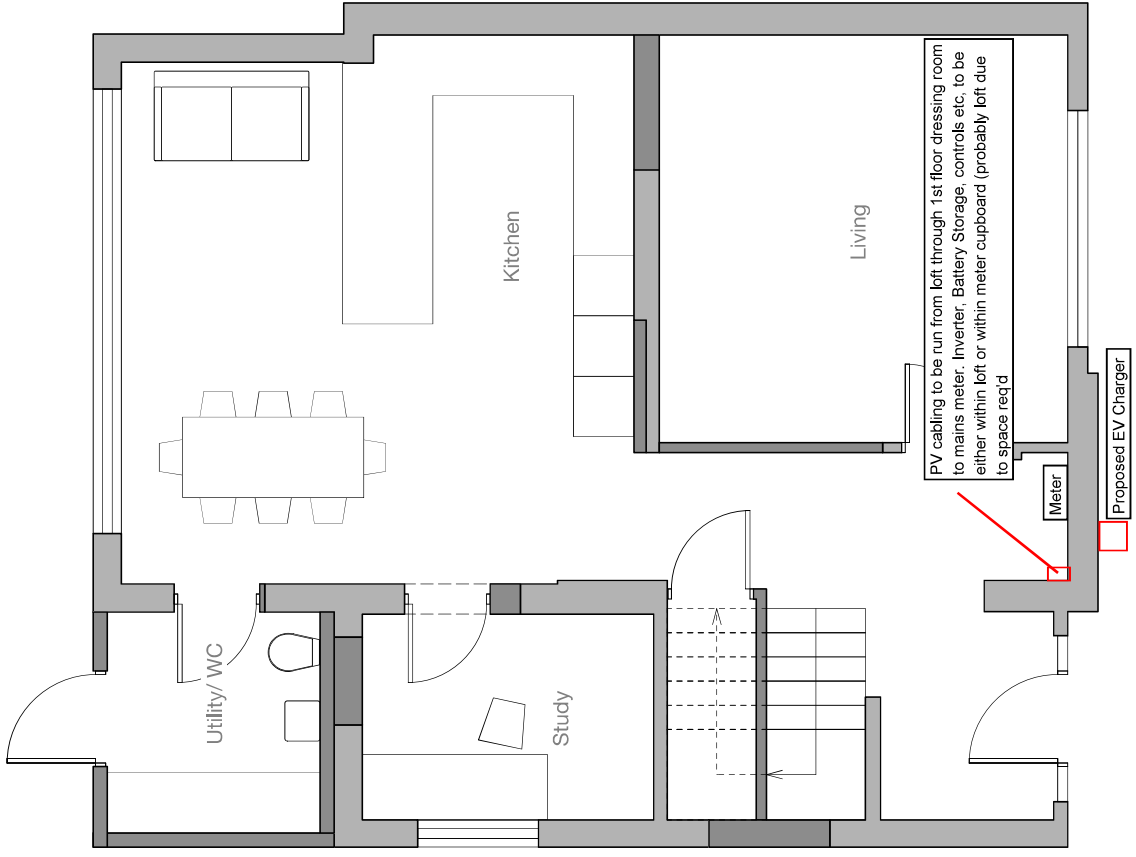

Proposed Ground Floor

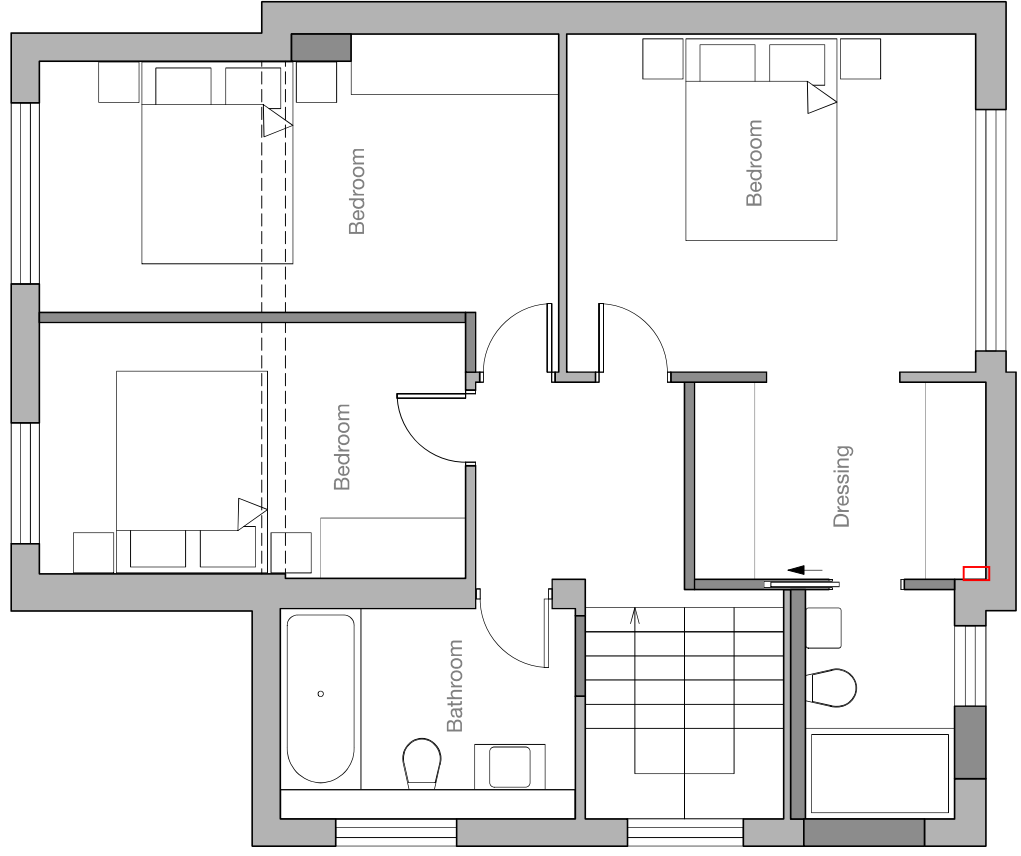

Proposed First Floor