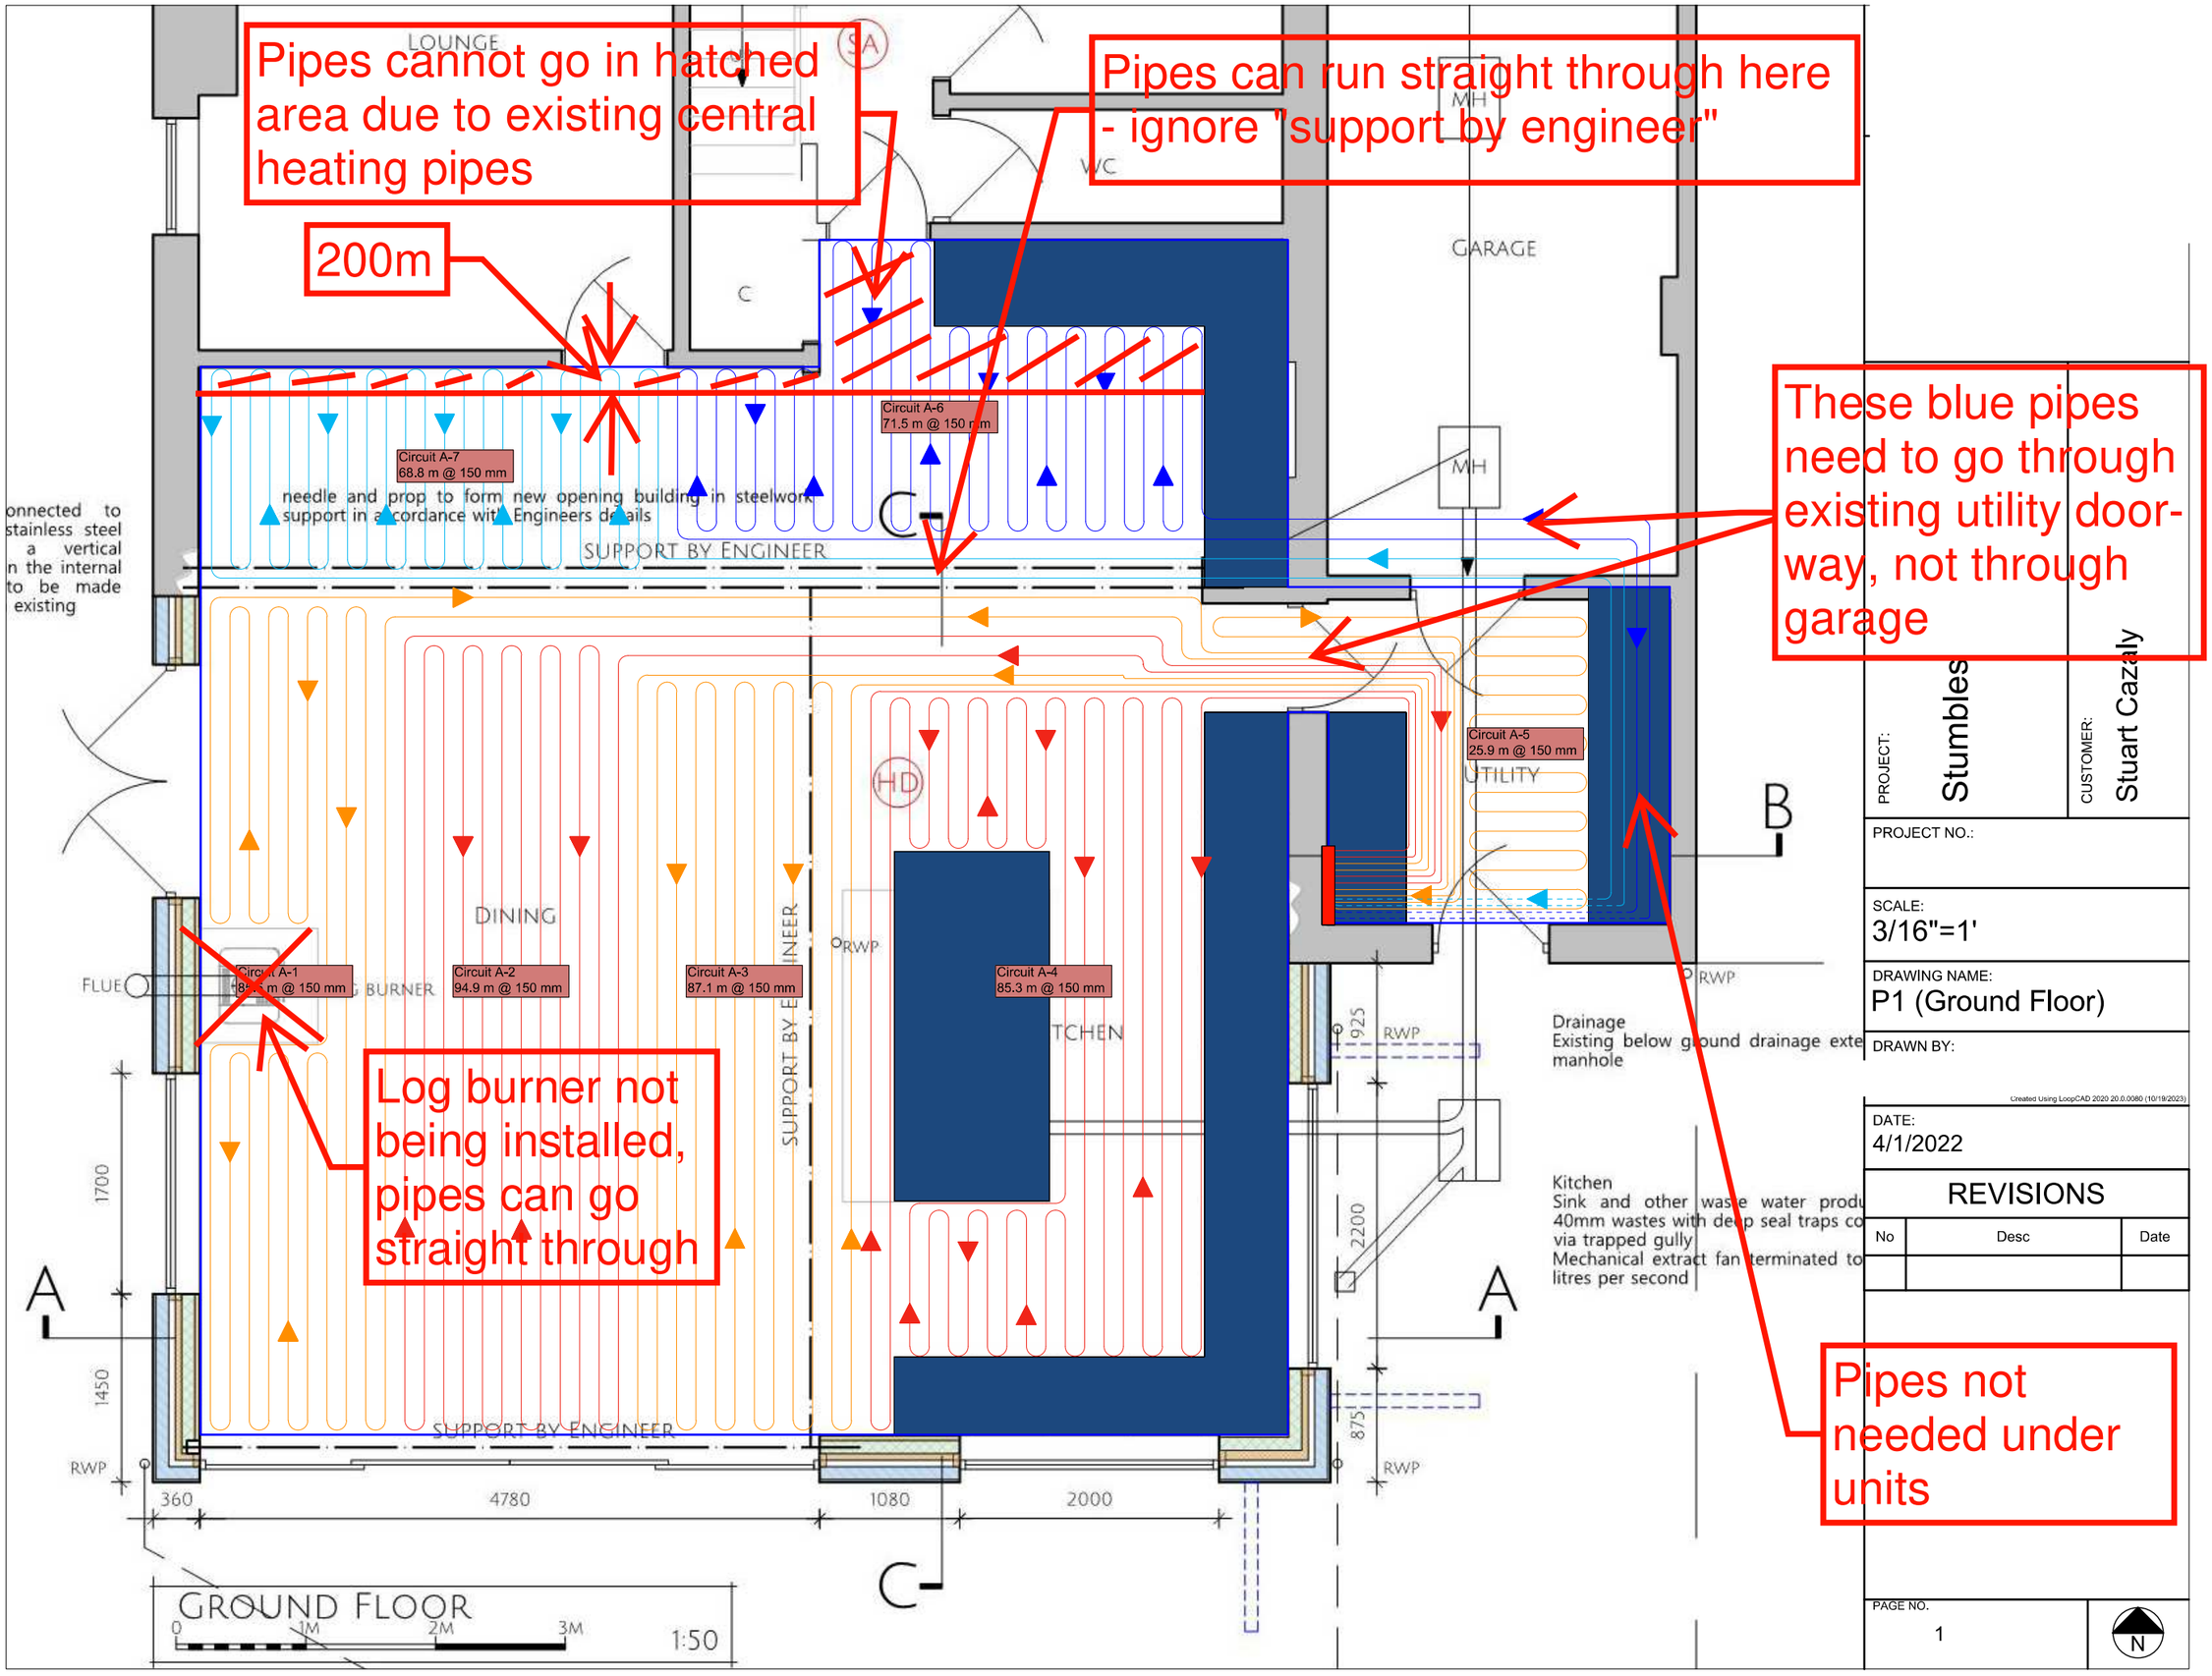
Pipes cannot go in hatched area due to existing central heating pipes
Pipes can run straight through here - ignore "support by engineer"
200m
These blue pipes need to go through existing utility door-way, not through garage
Log burner not being installed, pipes can go straight through
Pipes not needed under units
LOUNGE
WC
GARAGE
MH
UTILITY
DINING
KITCHEN
FLUE
BURNER
RWP
SUPPORT BY ENGINEER
needle and prop to form new opening building in steelwork support in accordance with Engineers details
Circuit A-1 87.1 m @ 150 mm
Circuit A-2 94.9 m @ 150 mm
Circuit A-3 87.1 m @ 150 mm
Circuit A-4 85.3 m @ 150 mm
Circuit A-5 25.9 m @ 150 mm
Circuit A-6 71.5 m @ 150 mm
Circuit A-7 68.8 m @ 150 mm
Drainage
Existing below ground drainage exte
manhole
Kitchen
Sink and other waste water produ
40mm wastes with deep seal traps co
via trapped gully
Mechanical extract fan terminated to
litres per second
360
4780
1080
2000
1700
1450
925
2200
875
GROUND FLOOR
1:50
PROJECT: Stumbles
CUSTOMER: Stuart Cazaly
PROJECT NO.:
SCALE: 3/16"=1'
DRAWING NAME: P1 (Ground Floor)
DRAWN BY:
Created Using LoopCAD 2020 20.0.0080 (10/19/2023)
DATE: 4/1/2022
REVISIONS
No
Desc
Date
PAGE NO. 1
N